



MARKET STREET ELEVATION. 3/85

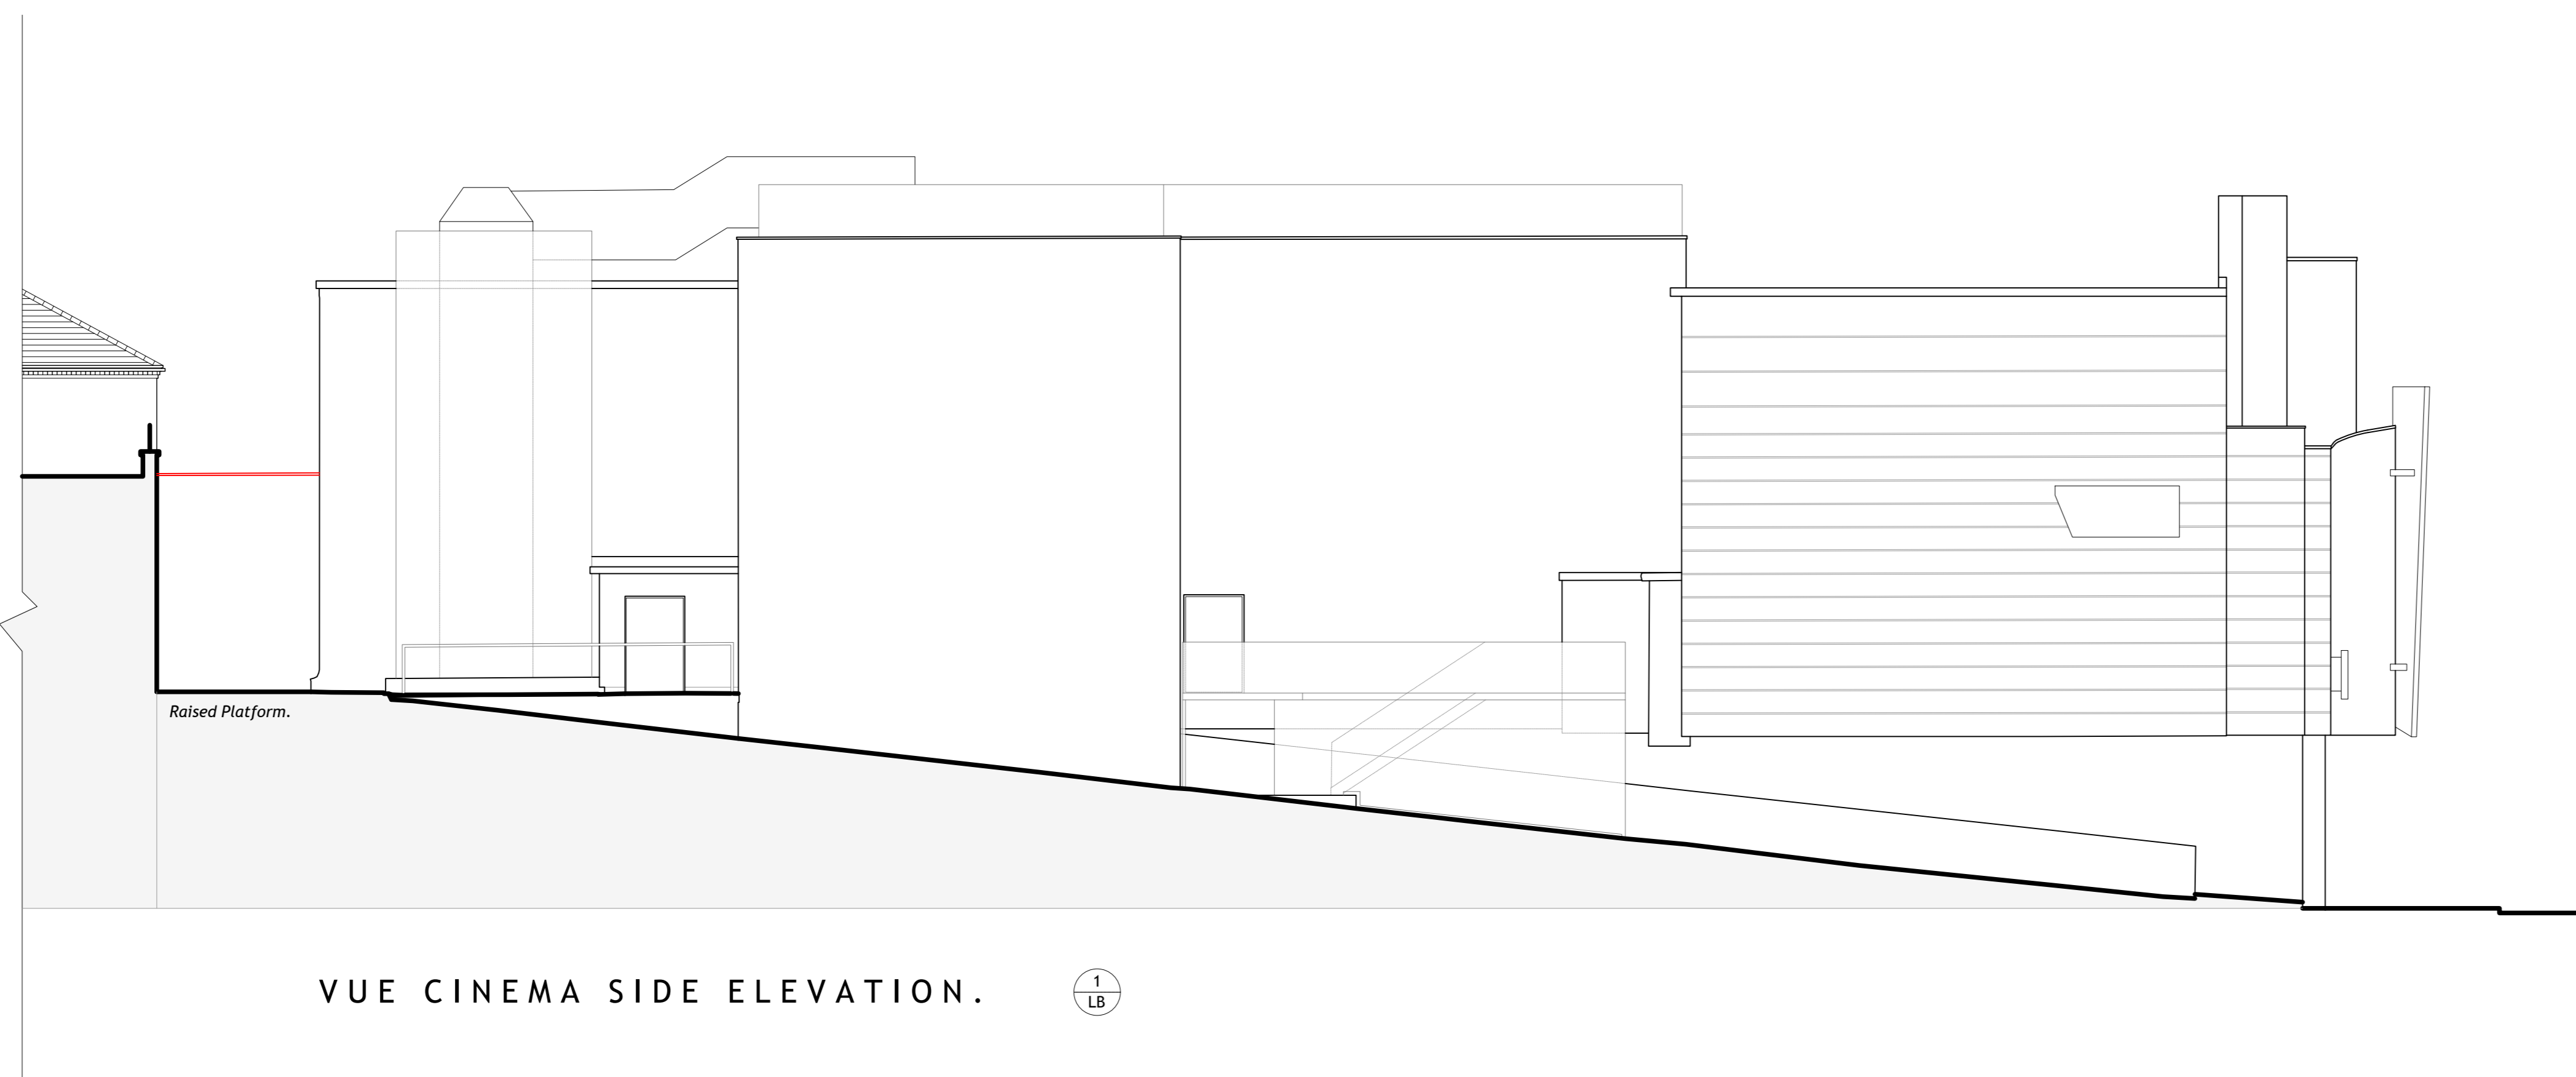

VUE CINEMA SIDE ELEVATION. 1/B

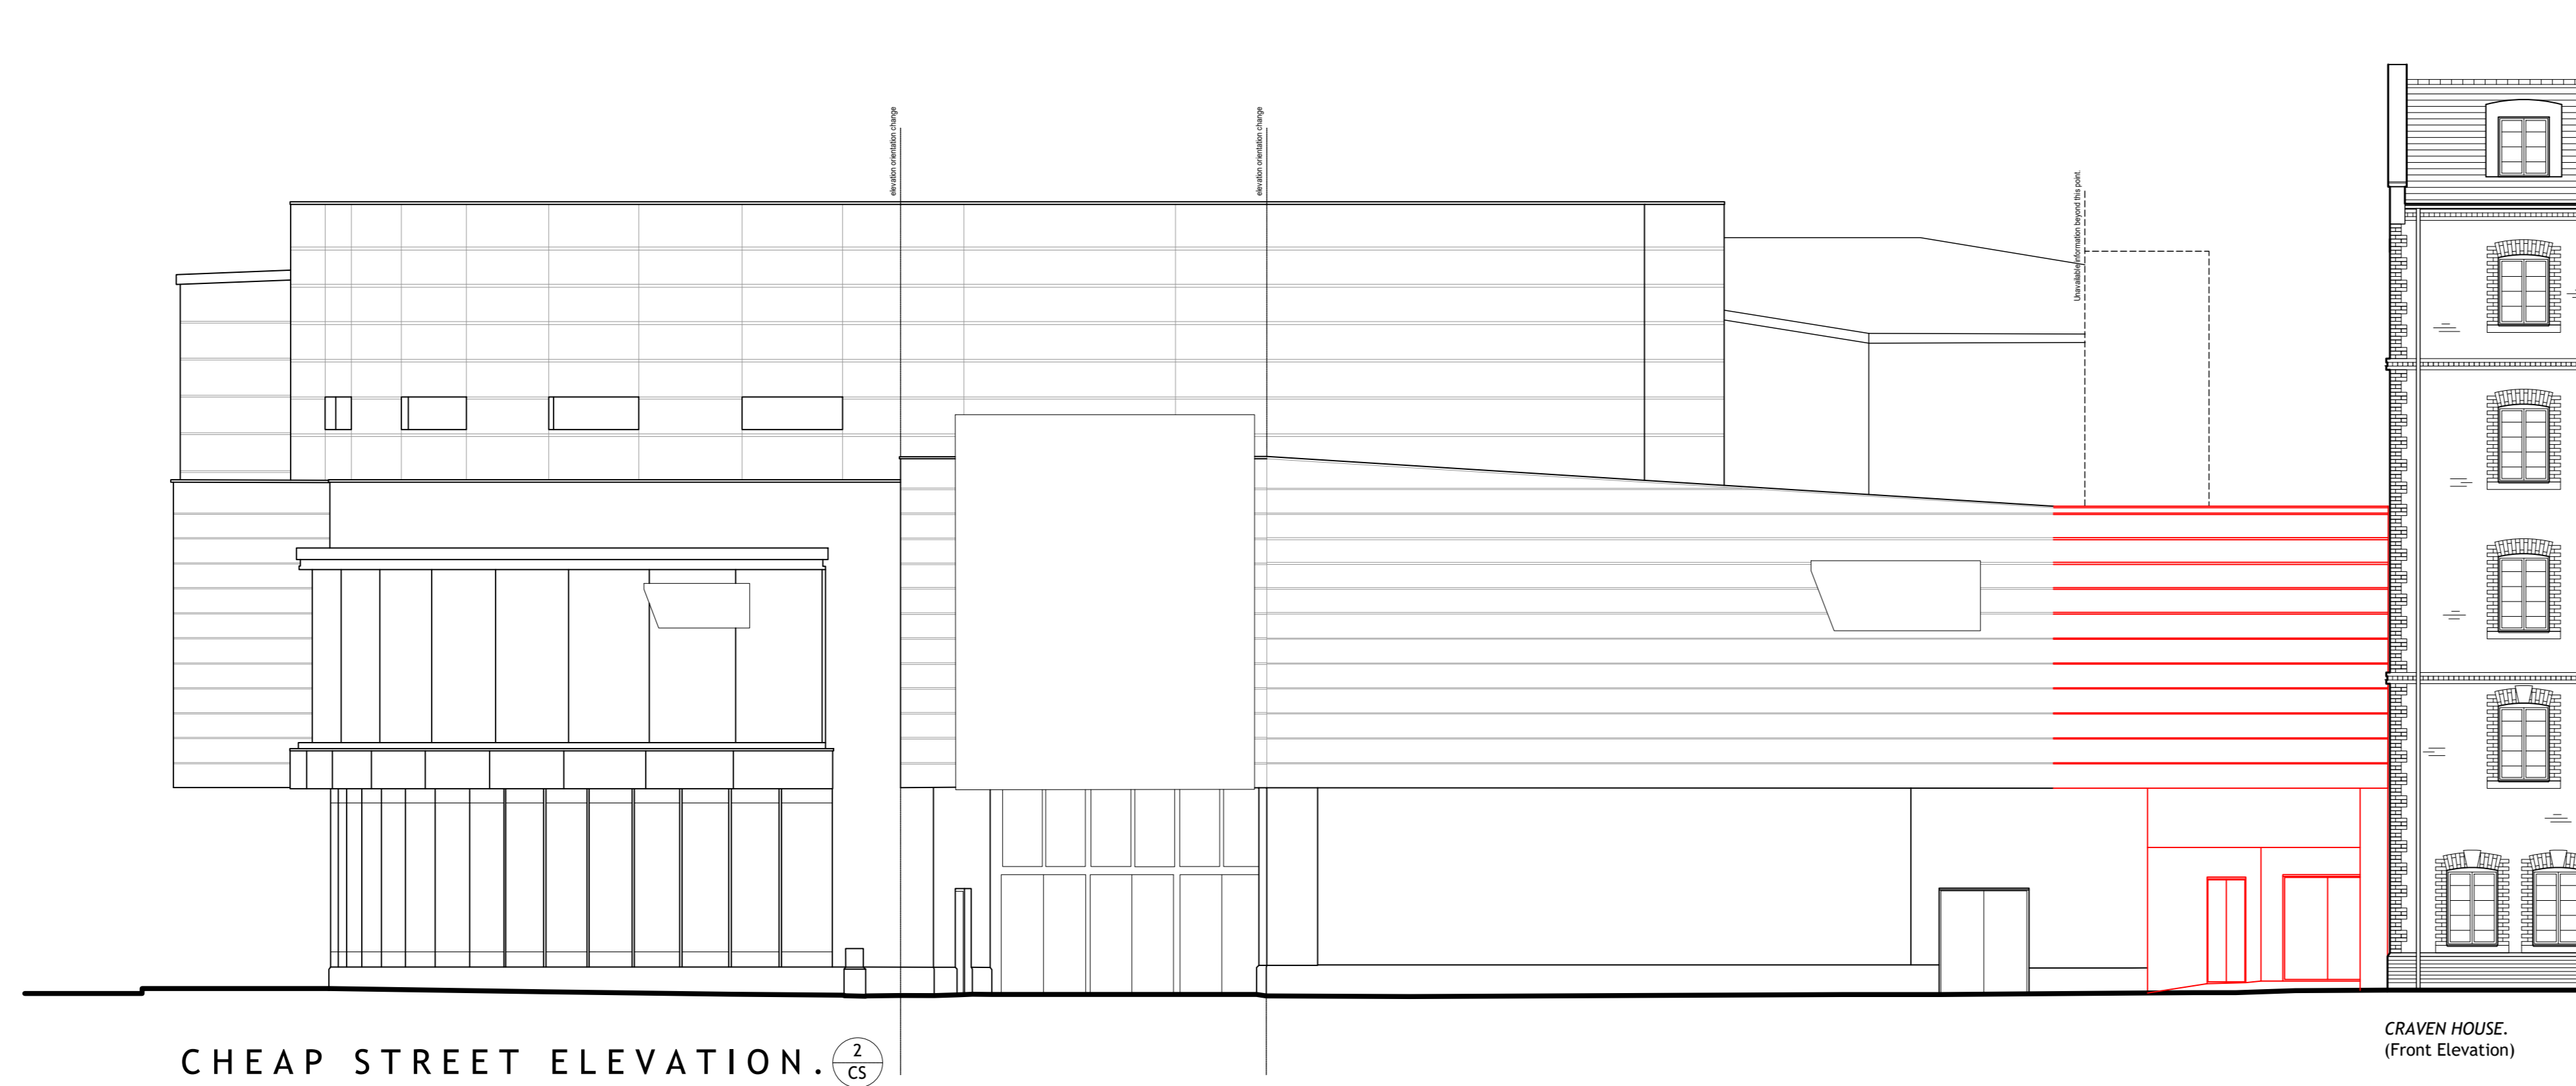

CHEAP STREET ELEVATION. 2/85

Craven House.
(Front Elevation)

NOTES

1. Contractors must check all dimensions on site. Only figured dimensions are to be worked from. Discrepancies must be reported to the Architect or Engineer before proceeding. © This drawing is copyright.
2. Reproduced from OS Sitemap © by permission of Ordnance Survey on behalf of The Controller of Her Majesty's Stationery Office. © Crown copyright 2008. All rights reserved. Licence number 100007124.
3. Direct scaling off the drawing is permissible for planning purposes only.
4. This Drawing has been prepared by Woods Hardwick based on the information provided by external sources. Therefore, Woods Hardwick does not accept liability for discrepancies occurring outside of Woods Hardwicks control.
5. Elevations Based on Survey Information.

Key
— Proposed Amendments to the Vue Cinema Red.

REV	DESCRIPTION	DRN	CHD	DATE	
<input type="checkbox"/>	PRELIMINARY	<input type="checkbox"/>	INFORMATION	<input type="checkbox"/>	TENDER
<input type="checkbox"/>	CONSTRUCTION	<input type="checkbox"/>	AS BUILT		
SCALE 1:100 @ A0		DATE JUN. 2024			
DRAWN AT		CHK JAL			
DRAWING NO. 19401/603		REV -			
TITLE Old Town, Newbury.					
DETAILS Elevations, Proposed Vue Cinema.					

LOCHAILORT

Woods Hardwick
 Architecture | Engineering | Planning | Surveying

BEDFORD : HEAD OFFICE
 15-17 Goldington Road
 Bedford MK40 3NH
 T: +44 (0) 1234 268862

BIRMINGHAM
 Fort Dunlop, Fort Parkway
 Birmingham B24 9FE
 T: +44 (0) 121 6297784

ONLINE: mail@woodshardwick.com | woodshardwick.com